


FIRST FLOOR PLAN - UNITS 220/250

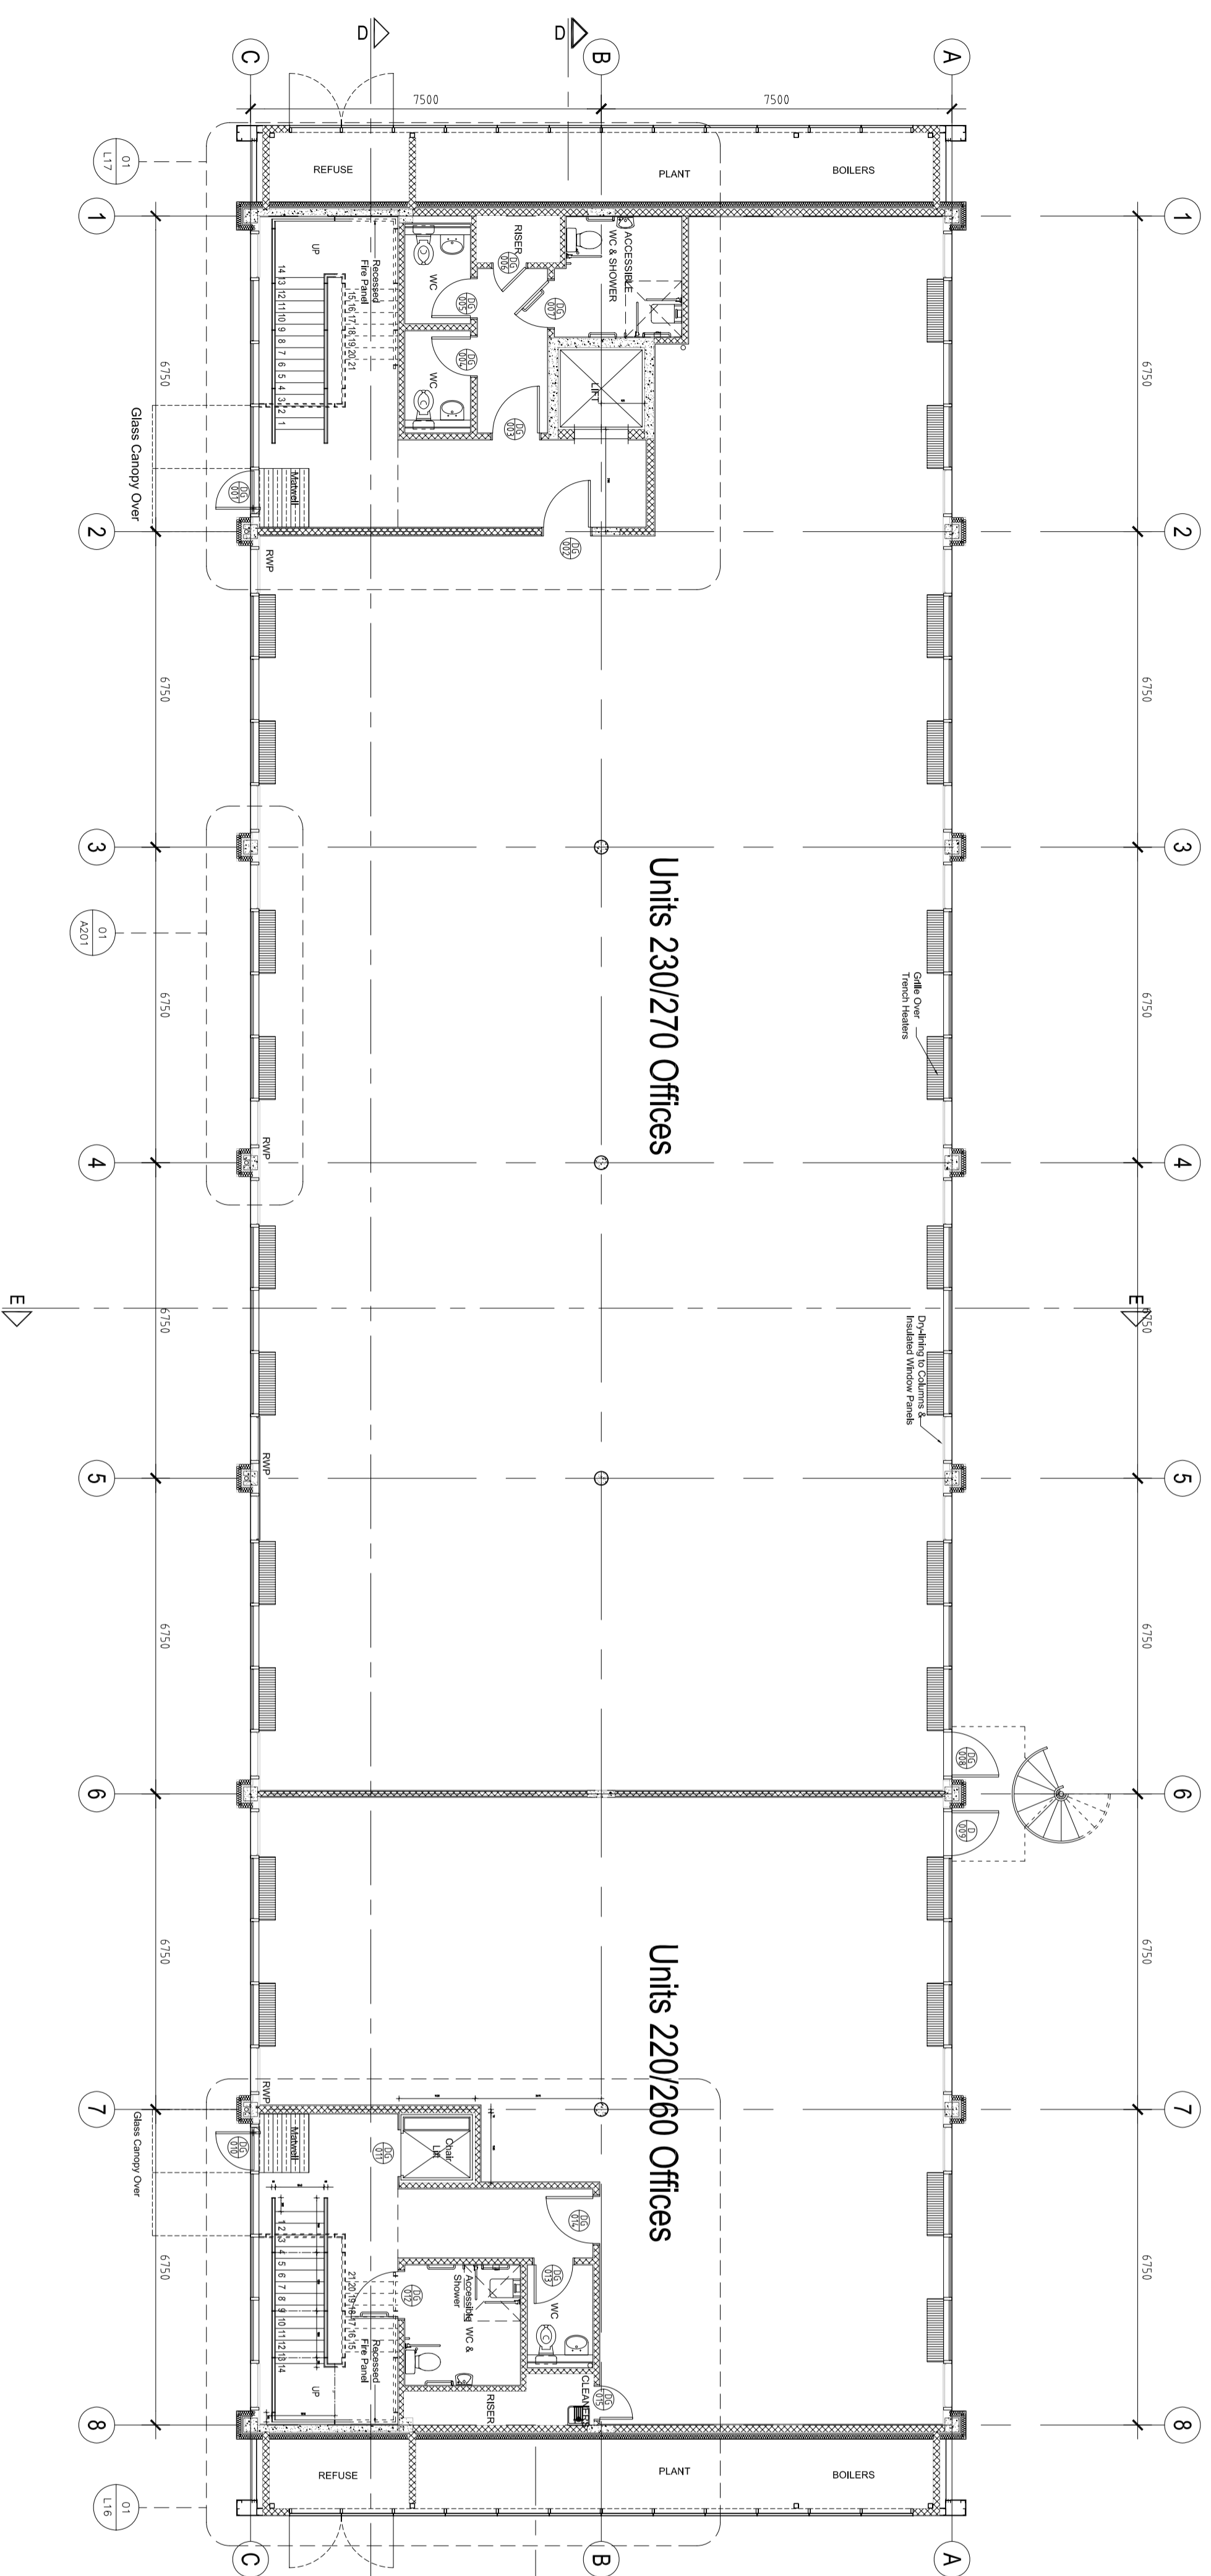

GROUND FLOOR PLAN - UNITS 220/250

C10	Record drawing issued	28.06.07	RJ	RJ
C9	Building Numbering Revised	13.04.07	RJ	RJ
C8	External plant rooms revised.	15.01.07	JL	RJ
C7	Door numbers added.	05.05.06	MR	RJ
C6	Units shall dimensions in small offices amended.	10.04.06	MR	RJ
C5	Handrailings on all stairs increased in depth by 100mm from 1200mm up to 1300mm.	28.02.06	MR	RJ
C4	Column types and RWF positions amended	06.02.06	MR	RJ
C3	Lifts in large offices amended.	02.02.06	MR	RJ
C2	Issued for Construction	11.01.06	MR	RJ
C1	Issued for Contract	08.11.05	MR	RL
Rev	Rev Note	Date	By	Issue

RECORD DRAWING

Do not scale from this drawing. Check all dimensions on site

hamilton associates
 280 Kings Road
 London SW3 5JW
 T: 020 7251 6432
 F: 020 7262 7261
 E: info@hamilton-associates.com
 www.hamiltonassociates.co.uk

Project:
 • **Butterfield, Luton**

Title:
 • **Office Units 220,230, 260 and 270**
 • **Ground, First Floor Plans**

Project No: **23195** Drawing No: **L12** Revision: **C10**
 Scale: 1:100 @ A1 CAD File No: N123195\CURCONS\SL-SEL12
 Date: 07.11.05 Drawn: MR Issue: HA